ICF/SK3-9-0-155

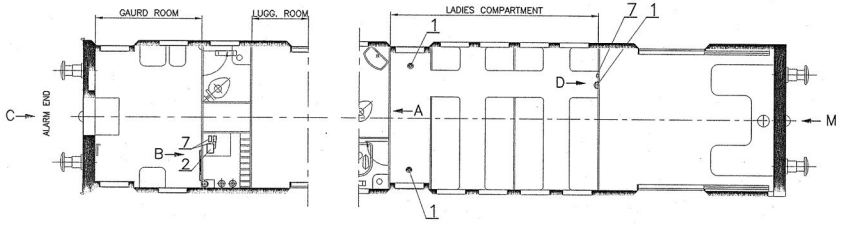

SLRD (COL–I)

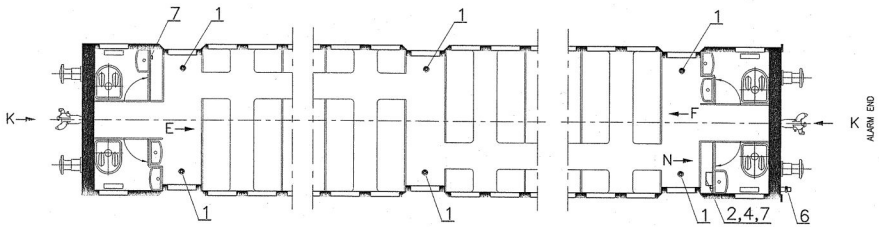

GS (COL–II)

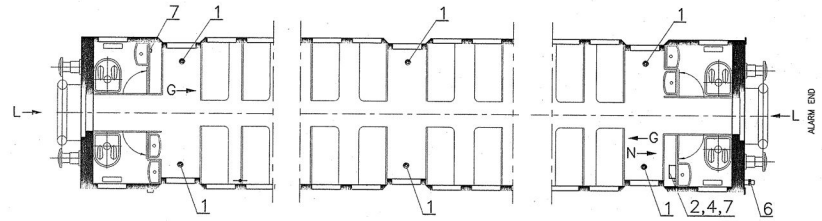

SDC (COL–II)

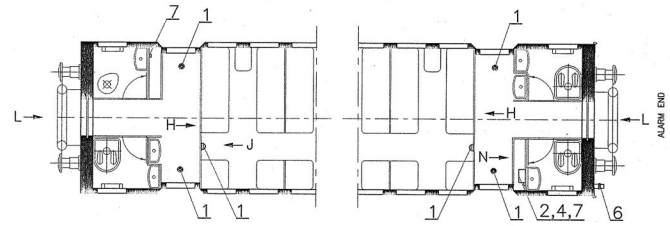

SCN (COL–III)

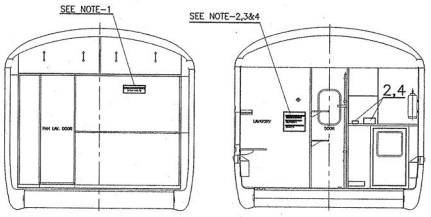

VIEW AT–A VIEW AT–B

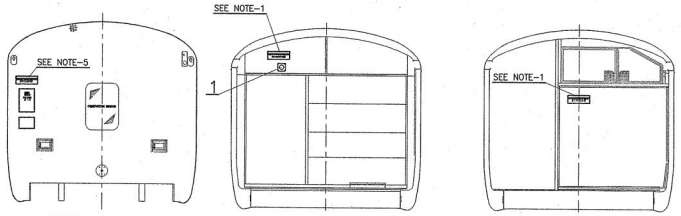

VIEW AT–C VIEW AT–D VIEW AT–E

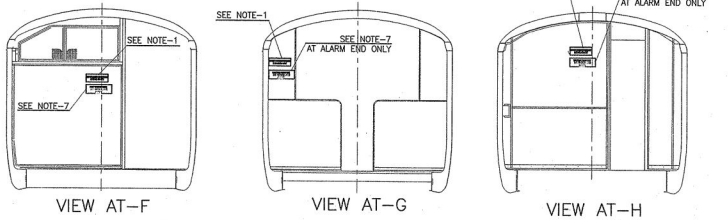

VIEW AT–F VIEW AT–G VIEW AT–H VIEW AT–J

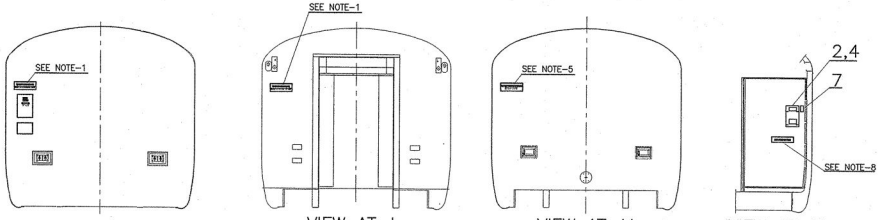

VIEW AT–K VIEW AT–L VIEW AT–M VIEW AT–N

NOTE:

1. NOTICE–THIS COMPARTMENT IS FITTED WITH SURVEILLANCE CAMERA FOR YOUR SAFETY.
2. NOTICE–SURVEILLANCE CAMERAS ARE FITTED IN THE LADIES COMPARTMENT OF THIS COACH FOR SAFETY.
3. NOTICE–THE NVR (NETWORK VIDEO RECORDER) IS KEPT IN THE GUARD ROOM UNDER LOCK SHALL BE HAND OVER/TAKEN OVER DURING CHANGE OF GUARD.
4. NOTICE–THE LOCK SHOULD BE OPEND ONLY BY AUTHORISED PERSONS OF RAILWAY.
5. NOTICE–COACH FITTED WITH SURVILLANCE CAMERA IN LADIES COMPARTMENT.
6. NECESSARY CUTAWAYS IN PANELS AND MOULDINGS SHALL BE DONE AT SITE.
7. NOTICE–NVR (NETWORK VIDEO RECORDER) IS KEPT INSIDE THE ELEC. CUBICLE (ALARM END)
8. NOTICE–PANIC BUTTON (OPTIONAL) INSIDE.

QTY			DESCRIPTION & DIMENSION	ITEM	REF.DRGS	MAT.SPEC	WEIGHT/UNIT	REMARKS
2	2	1	PANIC BUTTON (OPTIONAL)	7		ICF/MD/SPEC–269		
1	1	–	GSM & GPS ANTENNA	6		ICF/MD/SPEC–269		
~~2~~	~~1~~	~~1~~	~~HD DIGITAL CAMERA~~	5		ICF/MD/SPEC–269		
1	1	1	12V POWER SUPPLY	4		ICF/MD/SPEC–269		
~~–~~	~~–~~	~~1~~	~~DISPLAY MONITER~~	3		ICF/MD/SPEC–269		
1	1	1	NETWORK VIDEO RECORDER (NVR)	2		ICF/MD/SPEC–269		
6	6	3	IP CAMERA	1		ICF/MD/SPEC–269		
3	2	1	GROUP: 9–0				SUPERSEDED BY:	

PER COACH SCN | PER COACH GS,SDC | PER COACH SLRD

INSTALLATION OF CCTV CAMERA IN NON–AC COACHES

SUPERSEDES:ICF/SK3-9-0-155 ALT:c/–

SCALE 1:100 1:50 1:40 | SSE/D | CHD | ALTD s.sivaselvakumar | DRN G.S.M.REDDY

Alpha Alt:– d

DATA CODE NO. 329 | INDIAN RAILWAY STANDARDS | SHEET 1 OF 1

INTEGRAL COACH FACTORY CHENNAI–38

ICF/SK3–9–0–155

ASSEMBLY DRAWINGS

0	Num. Alt.	DATE OF LATEST ALT	DATE OF FIRST ISSUE	AME/SME
		24–10–2015	03–02–2015	

FORM:–IR.A1–840X600

▽ ROUGH MACHINED	(01) ROUGH CLEANED
▽▽ FINISH MACHINED	
▽▽▽ FINE FINISH MACHINED	

ALTERATIONS

(b) 08/2015
QTY. FOR GS,SDC,SCN WITH COL–II&III,ITEMS–5 TO 7 AND NOTE–7&8 ADDED. QTY FOR ITEM–1 ALTD FROM 4 TO 2 IN COL–I. NOTE–3 REVISED. DRG. REVISED ACCORDINGLY.
Sd/– SSE/D Sd/– SME/DSD

(c) 08/2015
DESCRIPTION OF ITEMS–1, 2&5 AND NOTE–3&7 REVISED.
Sd/– SSE/D Sd/– SME/DSD

(d) 10/2015
DESCRIPTION OF ITEMS–1&2 AND NOTE–3&7 REVISED. ITEM–3&5 DELETED. QTY OF ITEM–5 ADDED IN ITEM–1.
SSE/D SME/DSD

PRODUCED BY AN AUTODESK EDUCATIONAL PRODUCT

d.00